

LEFT ELEVATION

RIGHT ELEVATION

LEFT ELEVATION

RIGHT ELEVATION

LEFT ELEVATION

RIGHT ELEVATION

6-3 BEDROOM
BUILDING NO. 9, 22










(C)

4-3 BEDROOM
BUILDING NO. 1, 2, 3, 4, 5, 6, 7, 8, 19

(B)

4-5 BEDROOM
BUILDING NO. 21

(A)

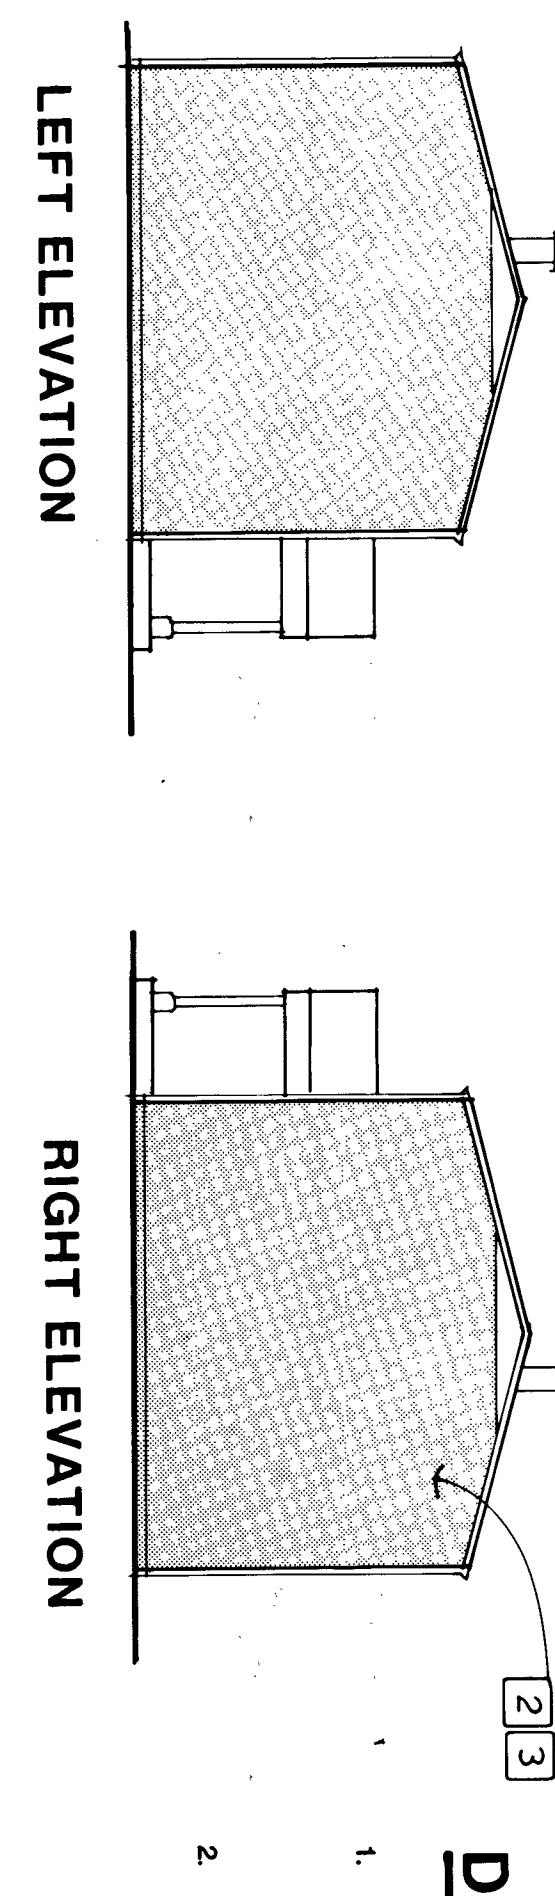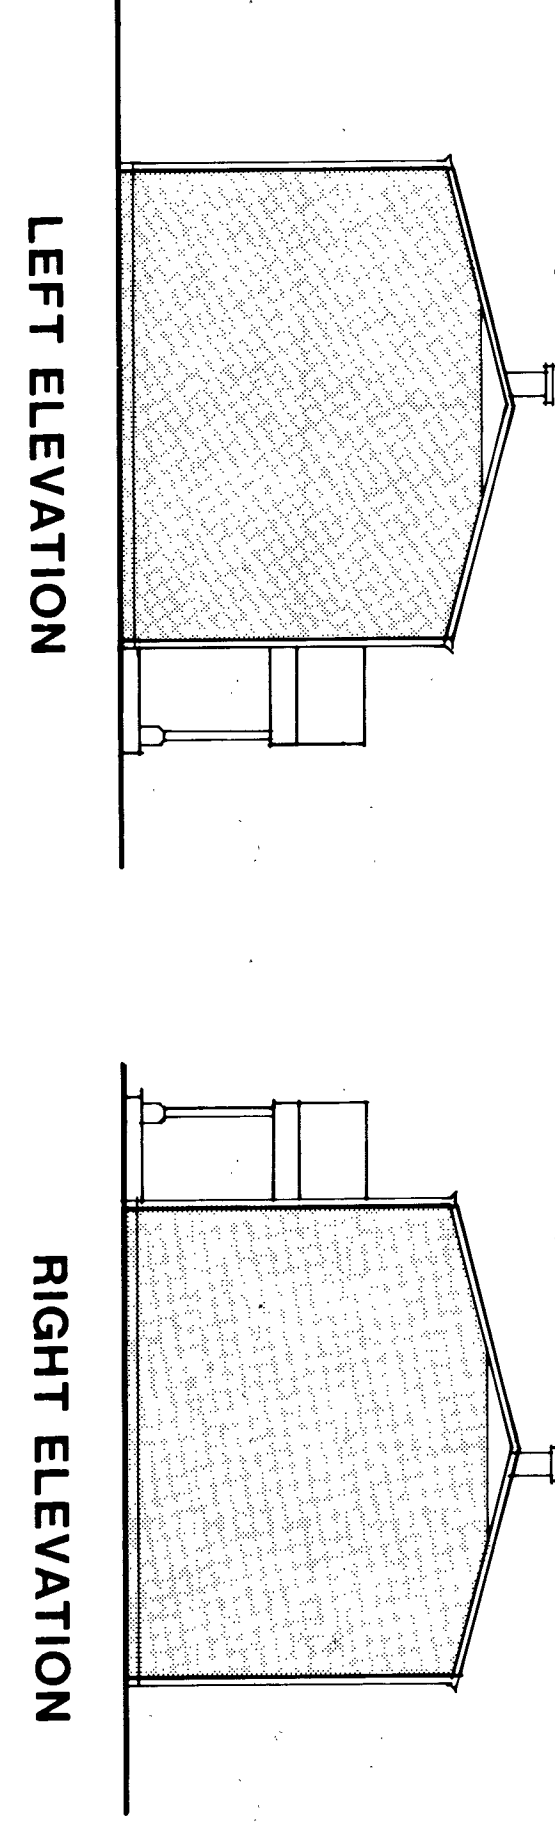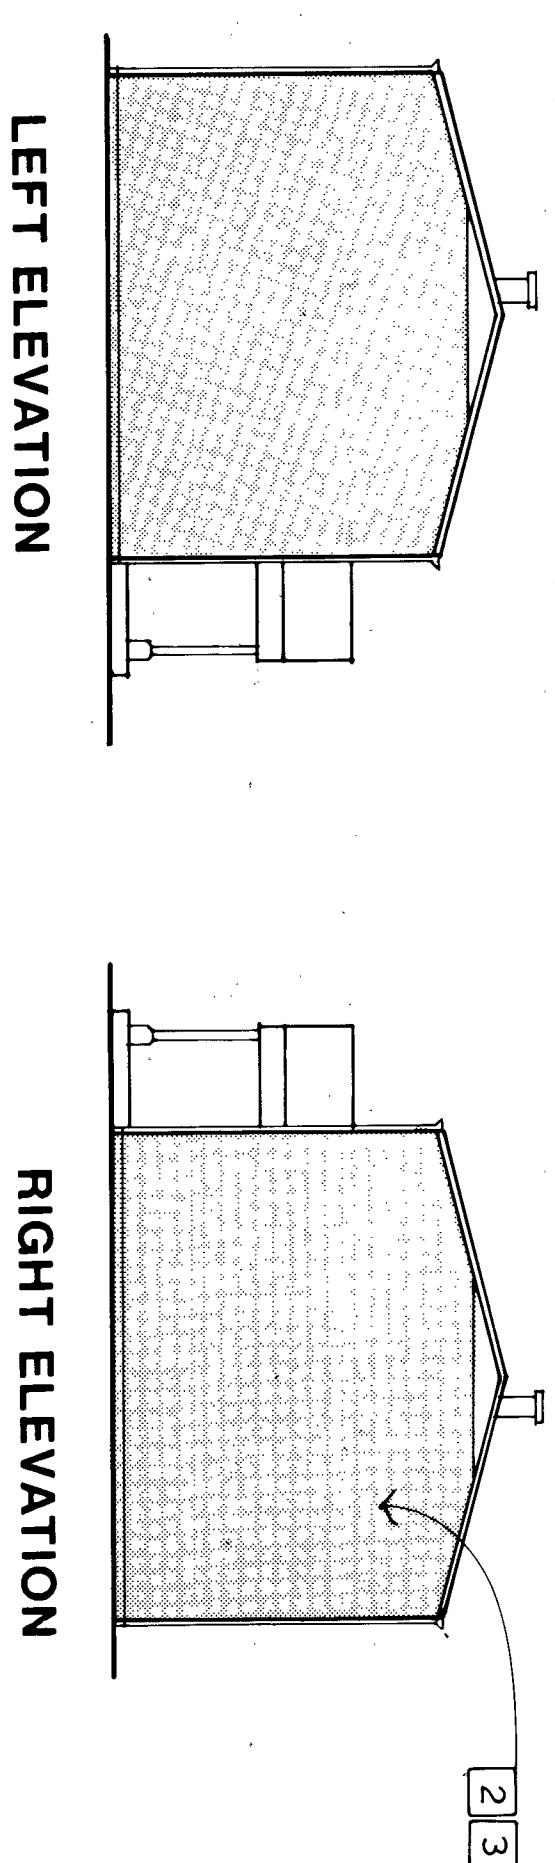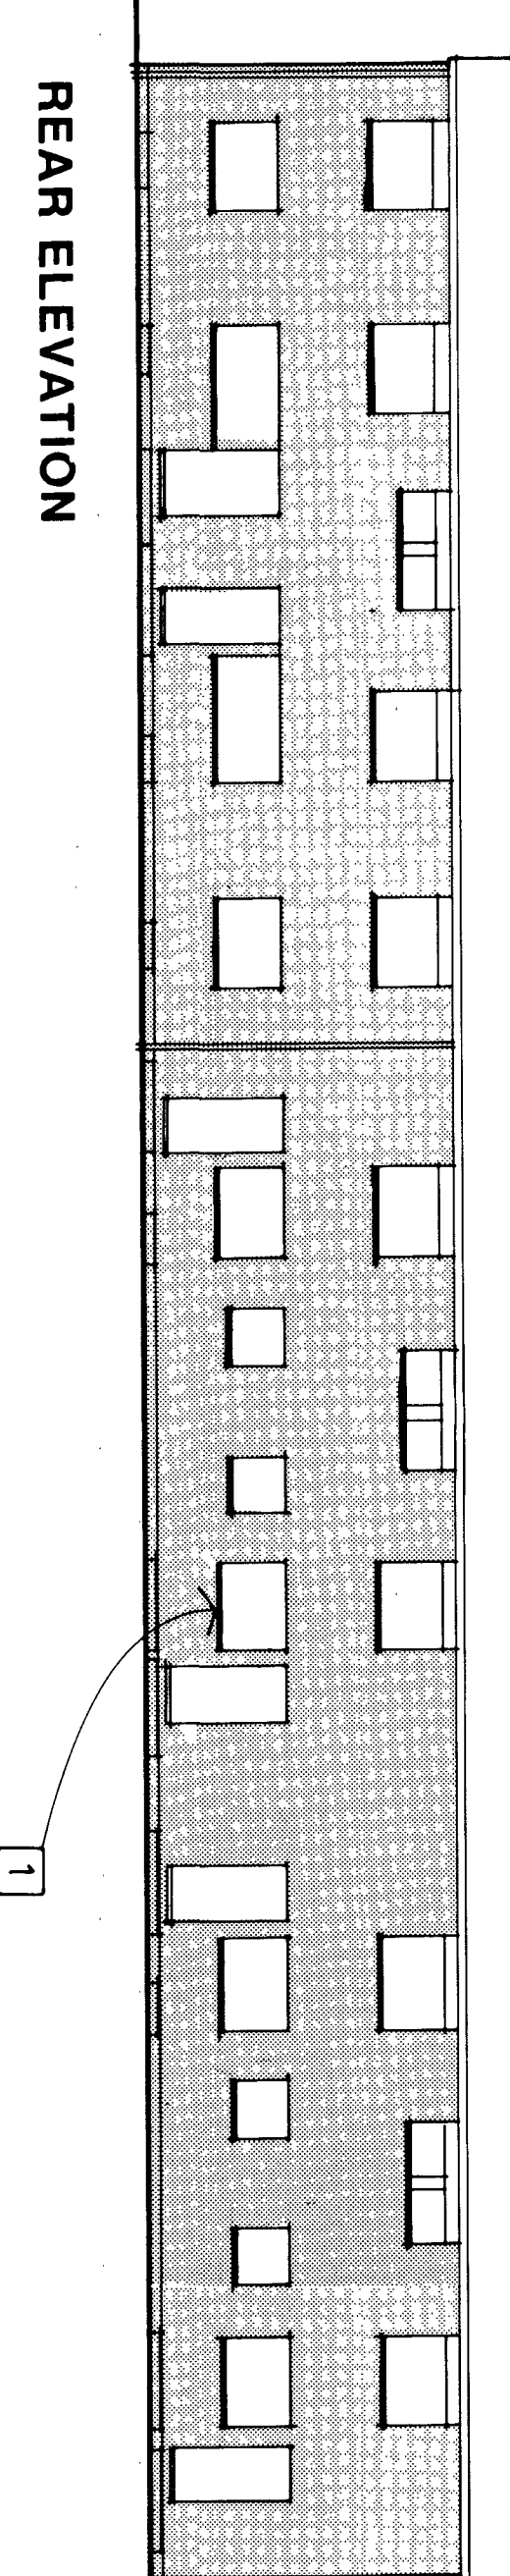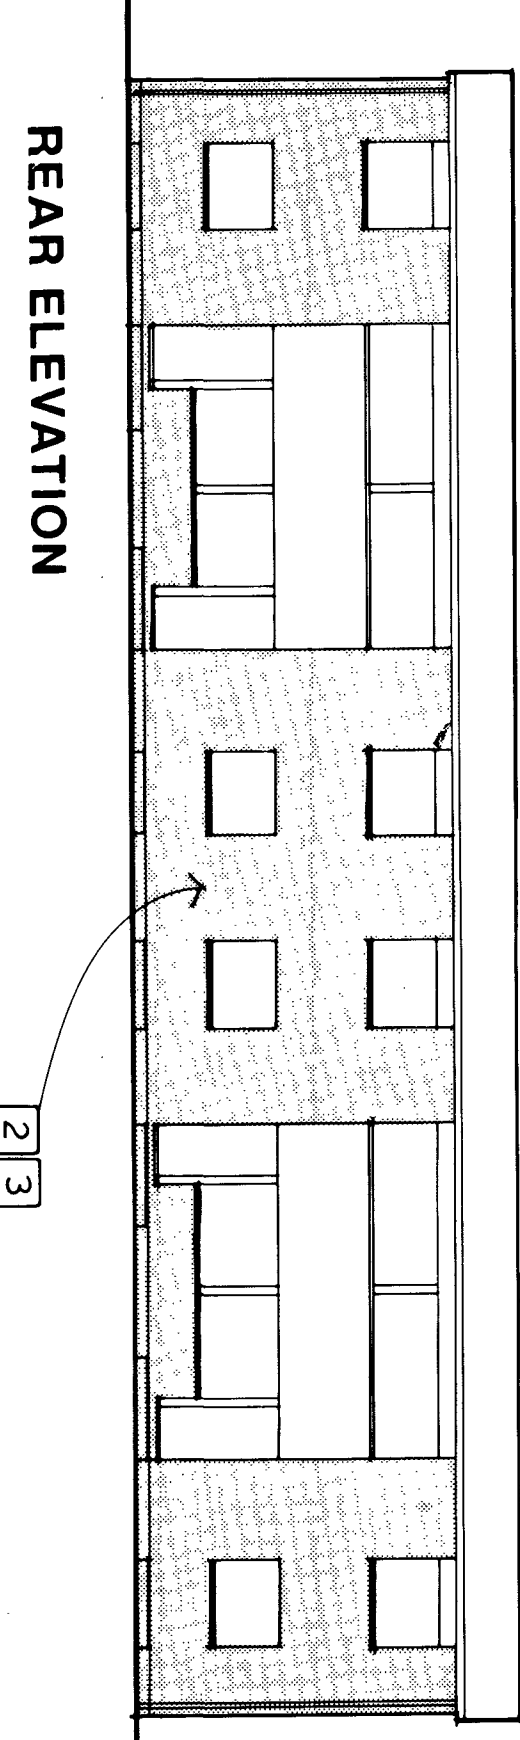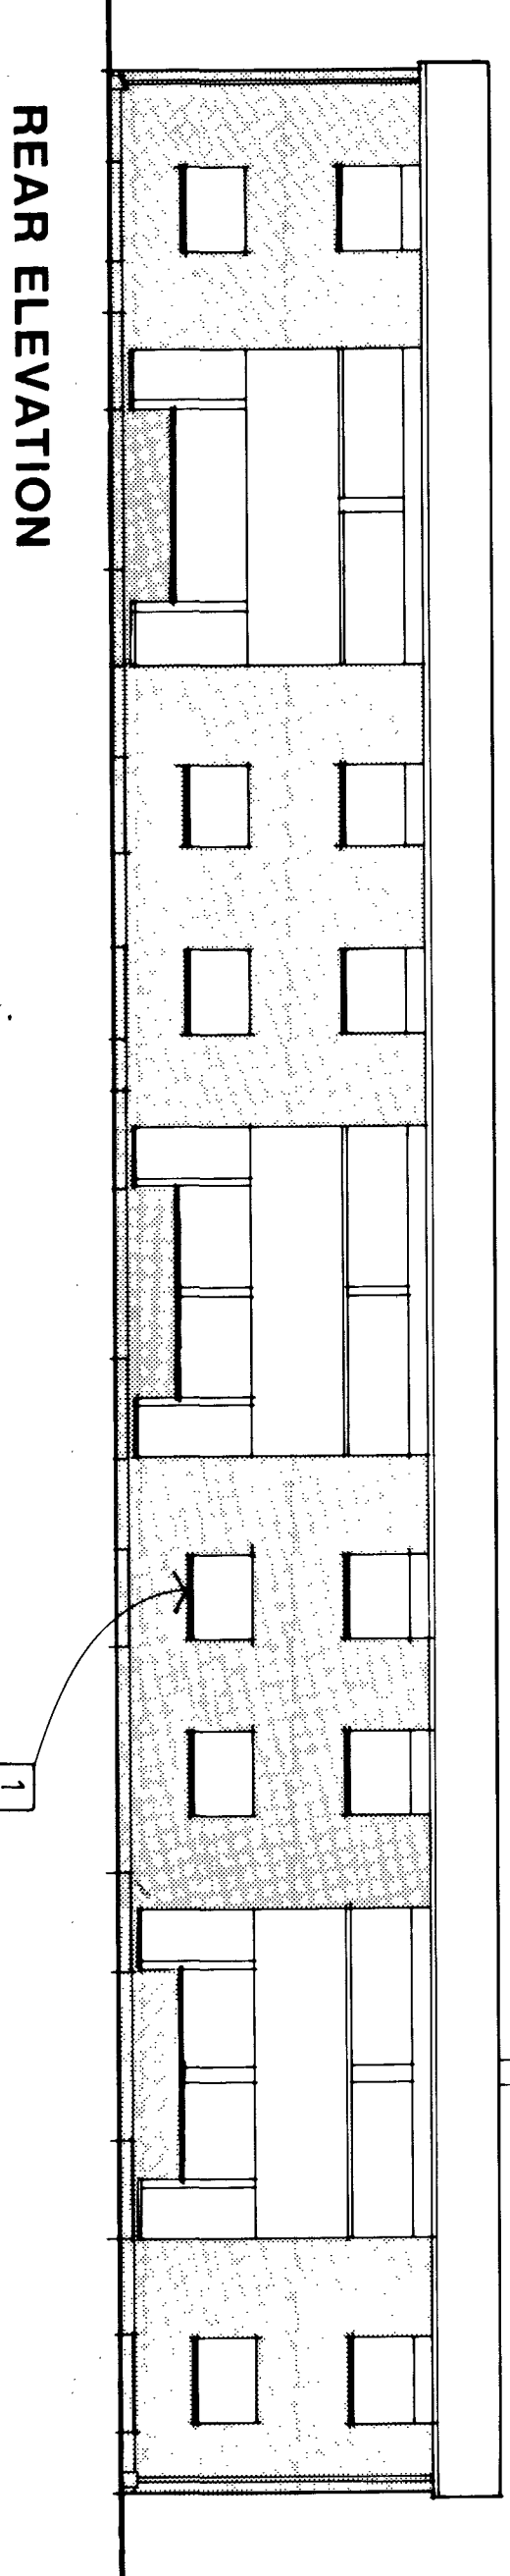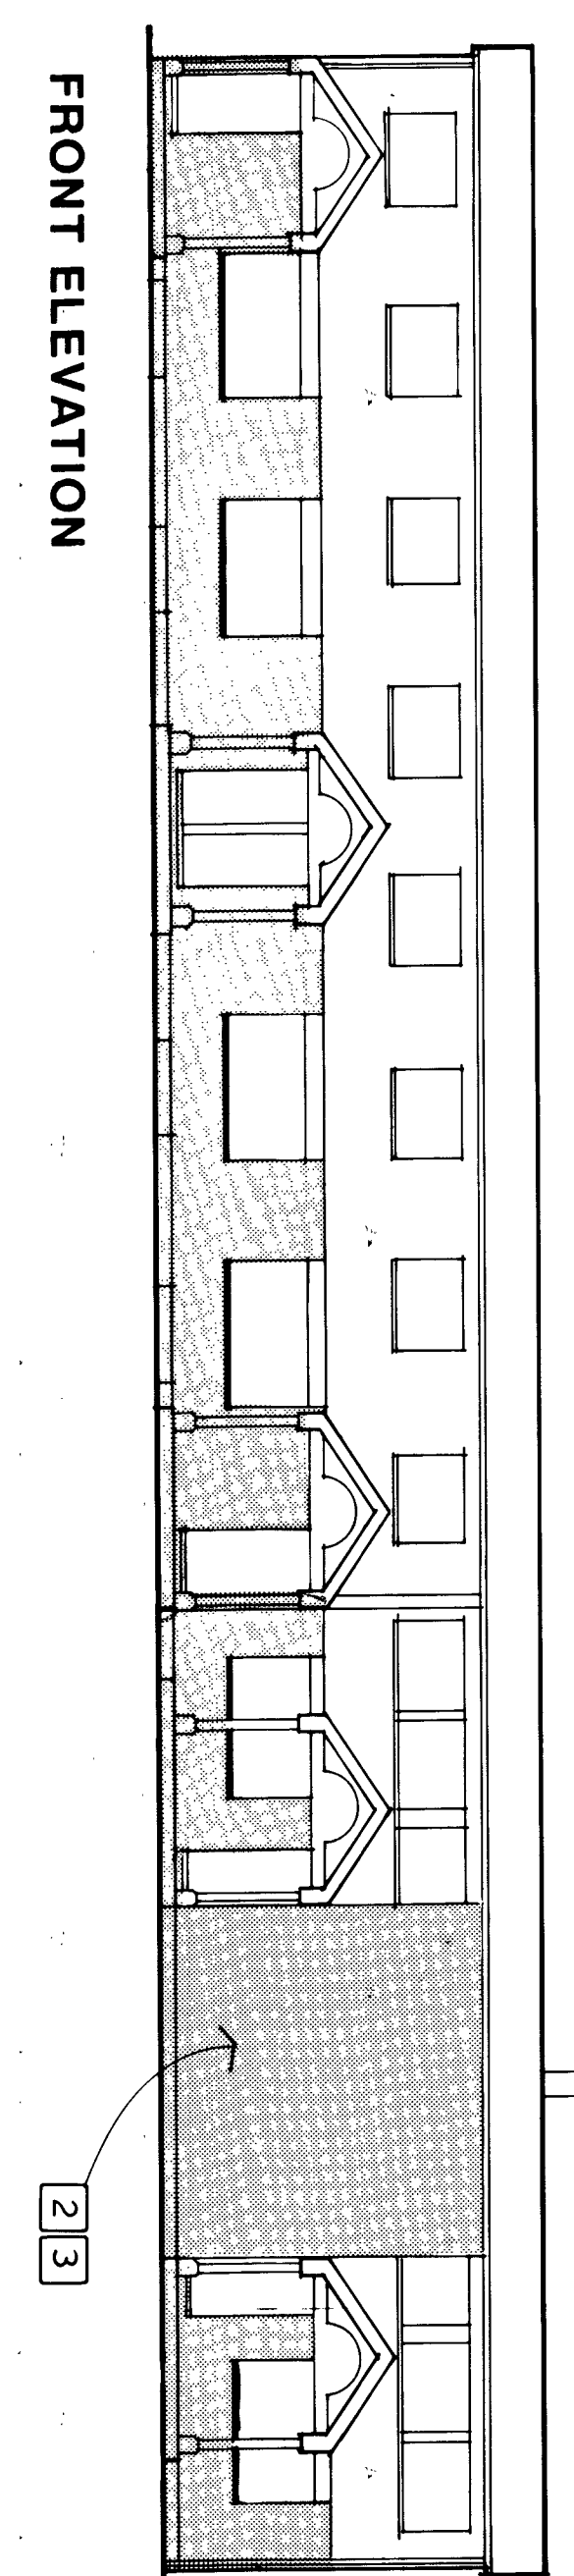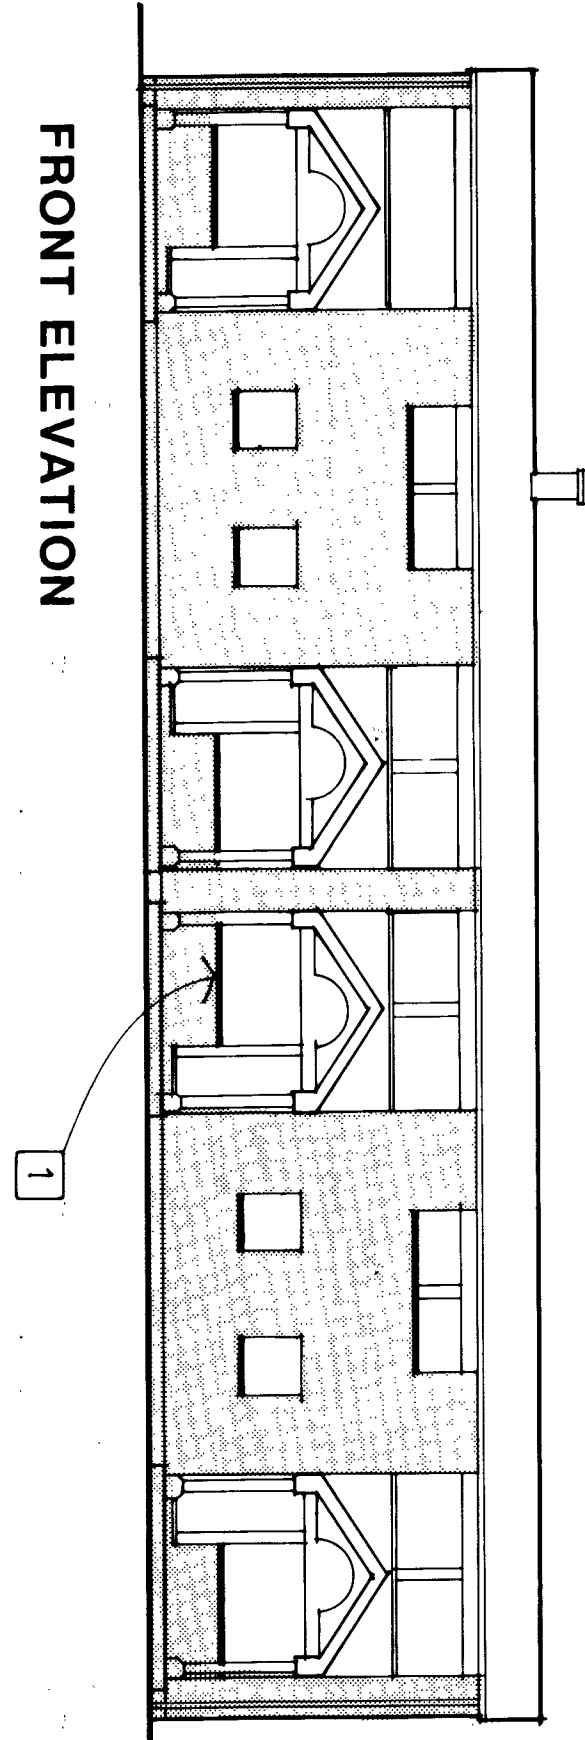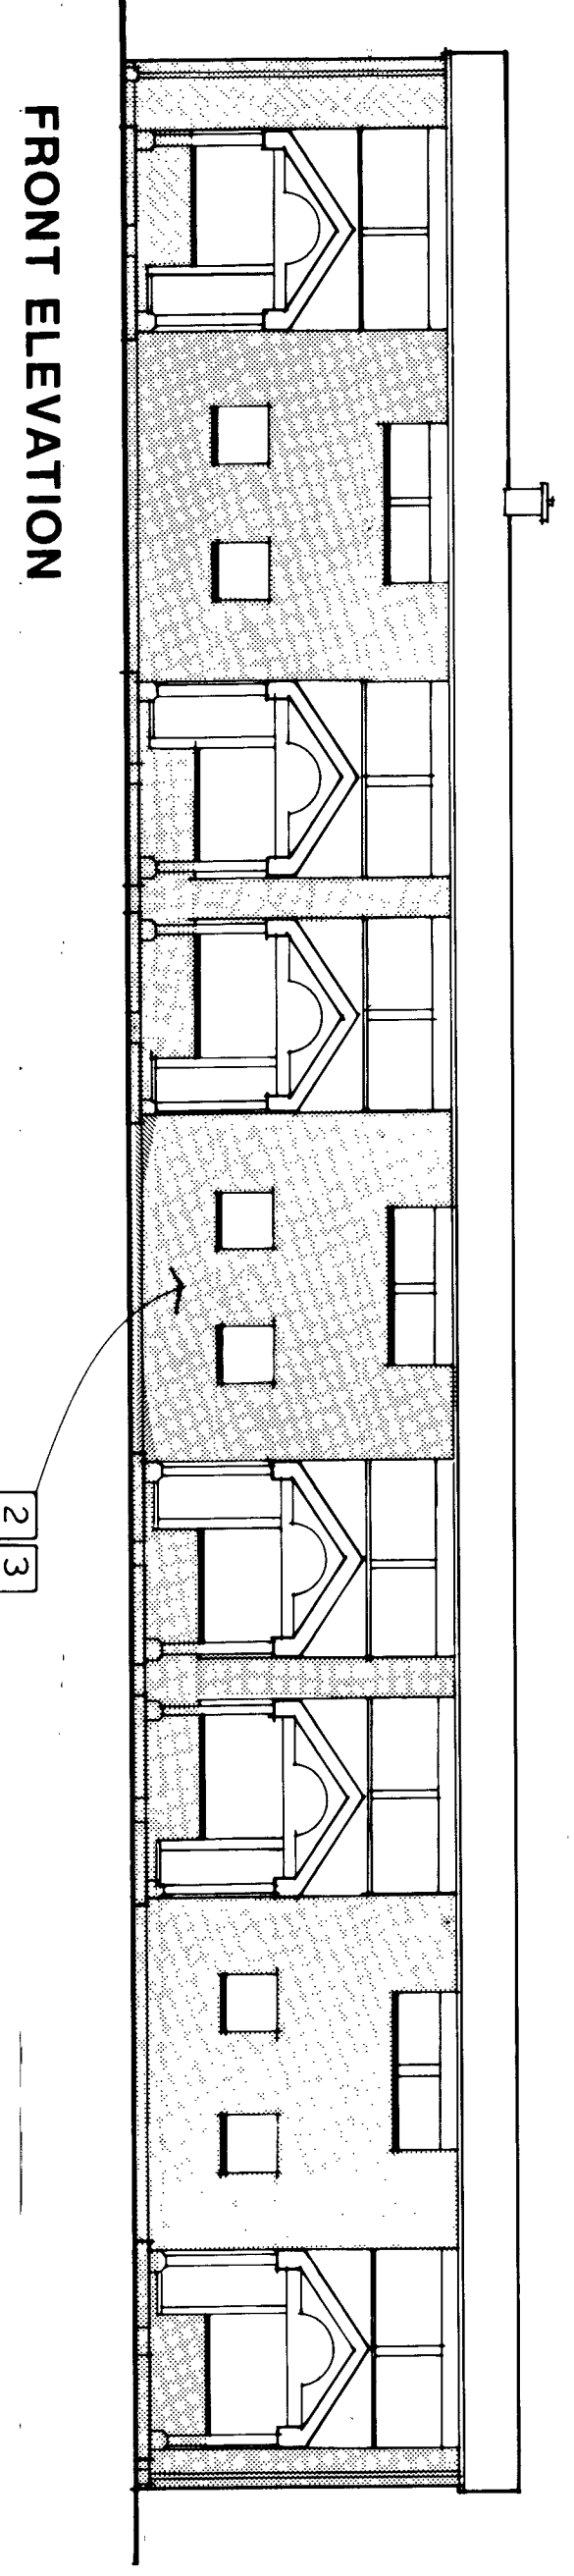

RIGHT ELEVATION

RIGHT ELEVATION

RIGHT ELEVATION

6-4 BEDROOM
BUILDING NO. 23





(F)

4-4 BEDROOM
BUILDING NO. 14, 15, 16, 17, 18, 20, 24

(E)

4-3 BEDROOM / 2-5 BEDROOM
BUILDING NO. 10, 11

(D)

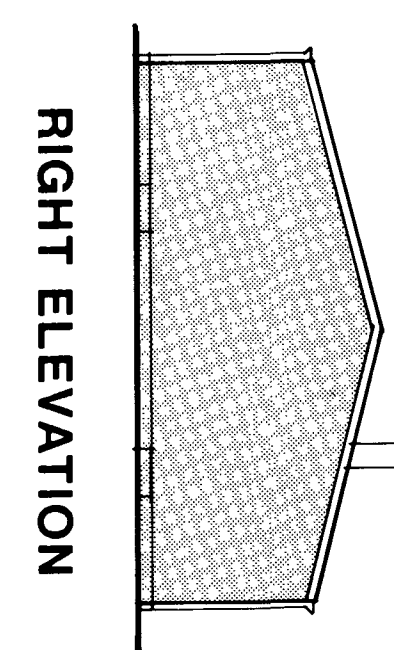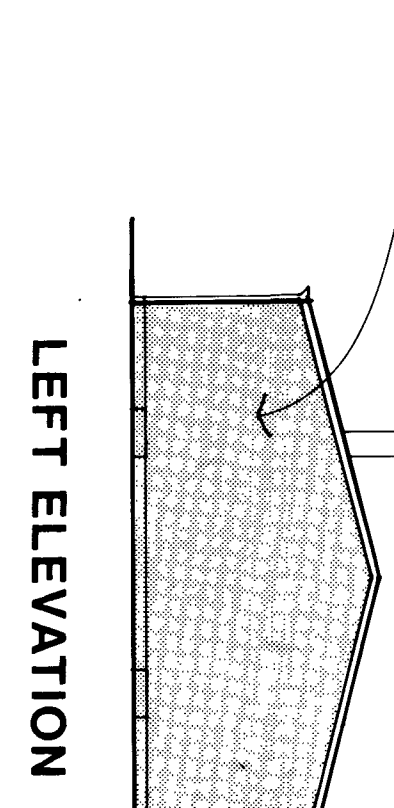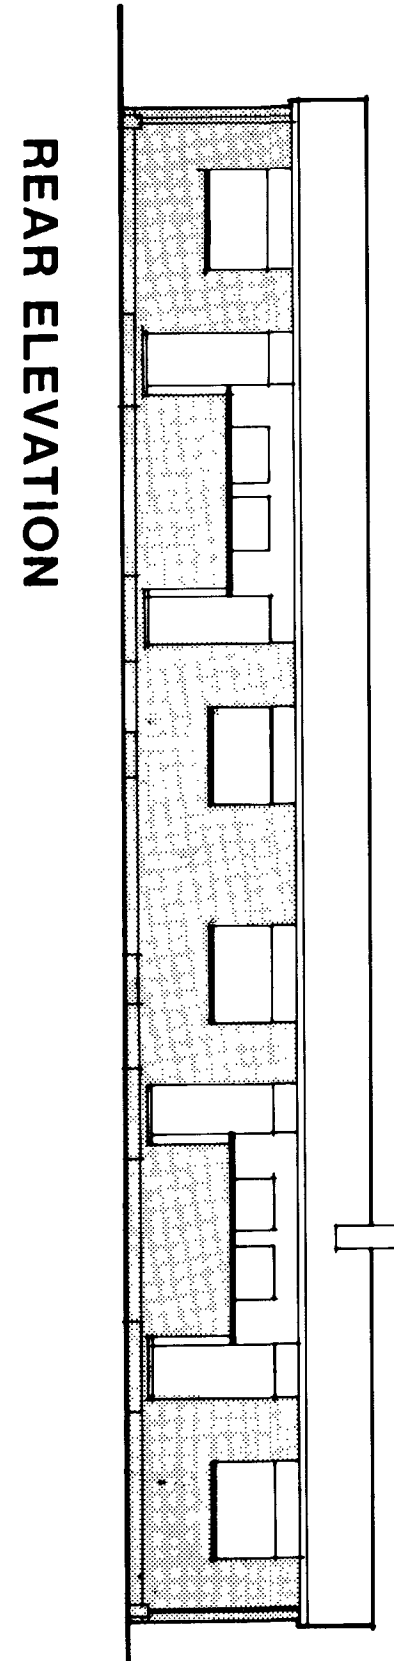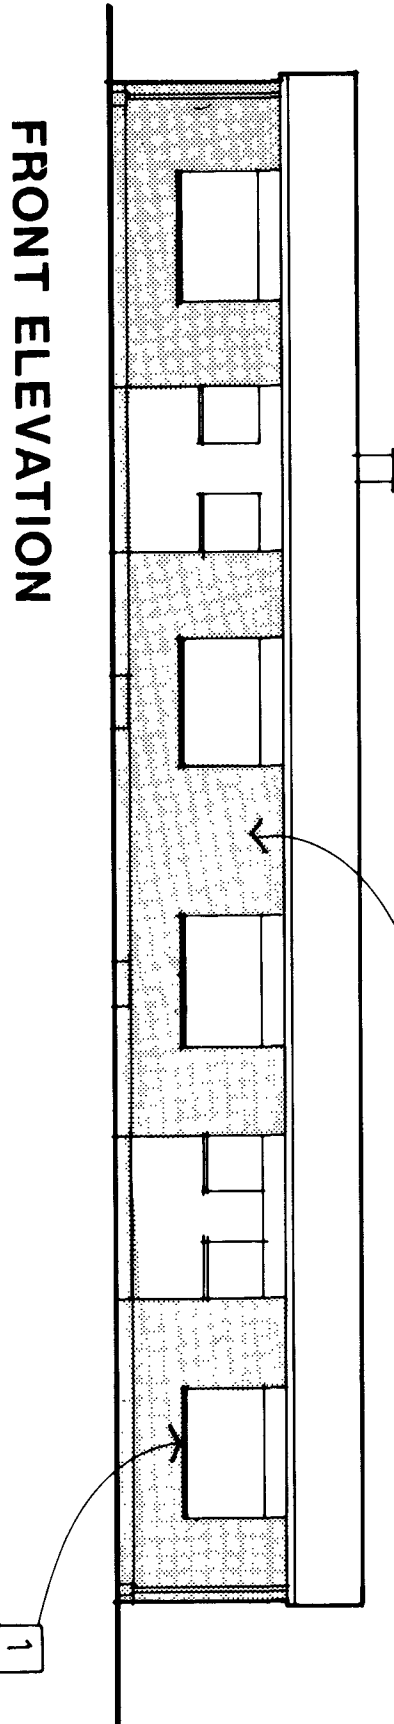

RIGHT ELEVATION

REAR ELEVATION

LEFT ELEVATION

RIGHT ELEVATION


4-1 BEDROOM
BUILDING NO. 12, 13

(G)

DRAWING NOTES

- REMOVE EXISTING STONE SILL AND METAL LINER EXPOSED ALUMINUM SILL. AS PER DETAILS. SEE REMOVAL OF EXISTING SILL DETAIL 918 AND NEW SILL DETAIL 918. TYPICAL AT ALL SHARDED SILLS OVER EXISTING BRICK VENEER.
- INSULATE EXTERIOR WALLS AT BRICK ONLY. BLOW IN ROCK WOOL INSULATION INTO THE WALL CAVITY BETWEEN THE EXISTING BRICK AND THE INSIDE FINISH. DRILLING 2 1/2" HOLES IN ALL EXTERIOR FLASTERED WALLS AT EVERY CAVITY AND FILLING WITH INSULATION. THEN PATCHING ALL HOLES.
- REPORT AND/OR REPLACE BRICK VENEER. TOTAL AREA OF BRICK TO BE REPORTED IS 10,000 LINEAR FEET AND A TOTAL OF 12 BRICKS ARE TO BE REPAIRED. CONFORM TO THE ARCHITECT'S SPECIFICATIONS AND REPAIRS TO BE APPROVED BY ARCHITECT BEFORE PROCEEDING.

INSTALLATE PERIMETER OF WINDOWS WHERE NEW EXPOSED SILL ARE TO BE INSTALLED. SEE CD # 9.1.1.1.1.1.5 CO # 5 CAULK ALL WINDOWS IN VERT. SECT. DETAILS. SEE CD # 5

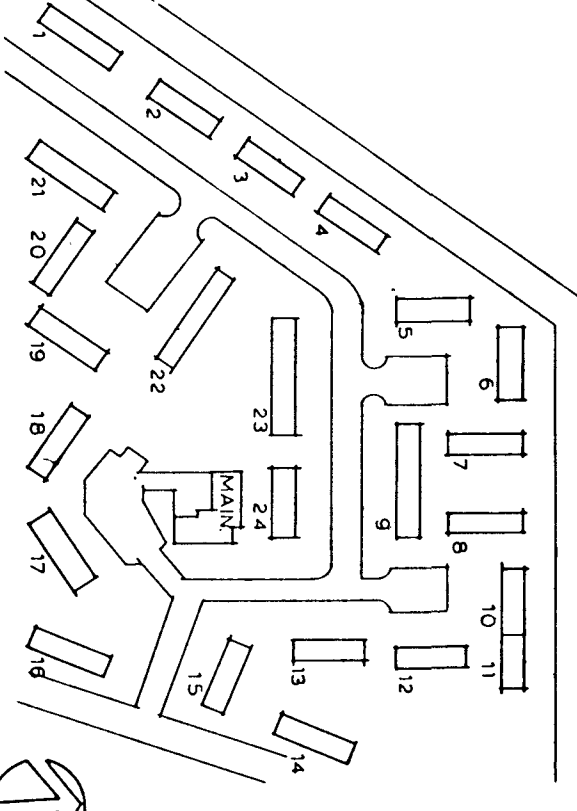

WARNING: ATTENTION TO THIS DOCUMENT NOT CONCERNING TO SECTION 2002.24.63.63.01. STATE EDUCATION LAW, AND REGULATIONS THEREUNDER. NOT PUBLISHED. ALL RIGHTS RESERVED.

LMW	WAS	MCF	RM/G

PERSONS
11 AM 44 - AS QUARTS

JORDAN GARDENS - CIAP
NIAGARA FALLS HOUSING AUTHORITY
HIGHLAND AVE. AT EASTON DR.
NIAGARA FALLS, NEW YORK

NY 11-2

Trautman King Maxwell Associates P.C. Architects and Engineers
476 Franklin Street Buffalo, NY 14202 736-883-4400

EXTERIOR ELEVATION
TRAUTMAN ASSOCIATES

92025
3-2-110
16 NOV 92
RECORD DRAWING
7