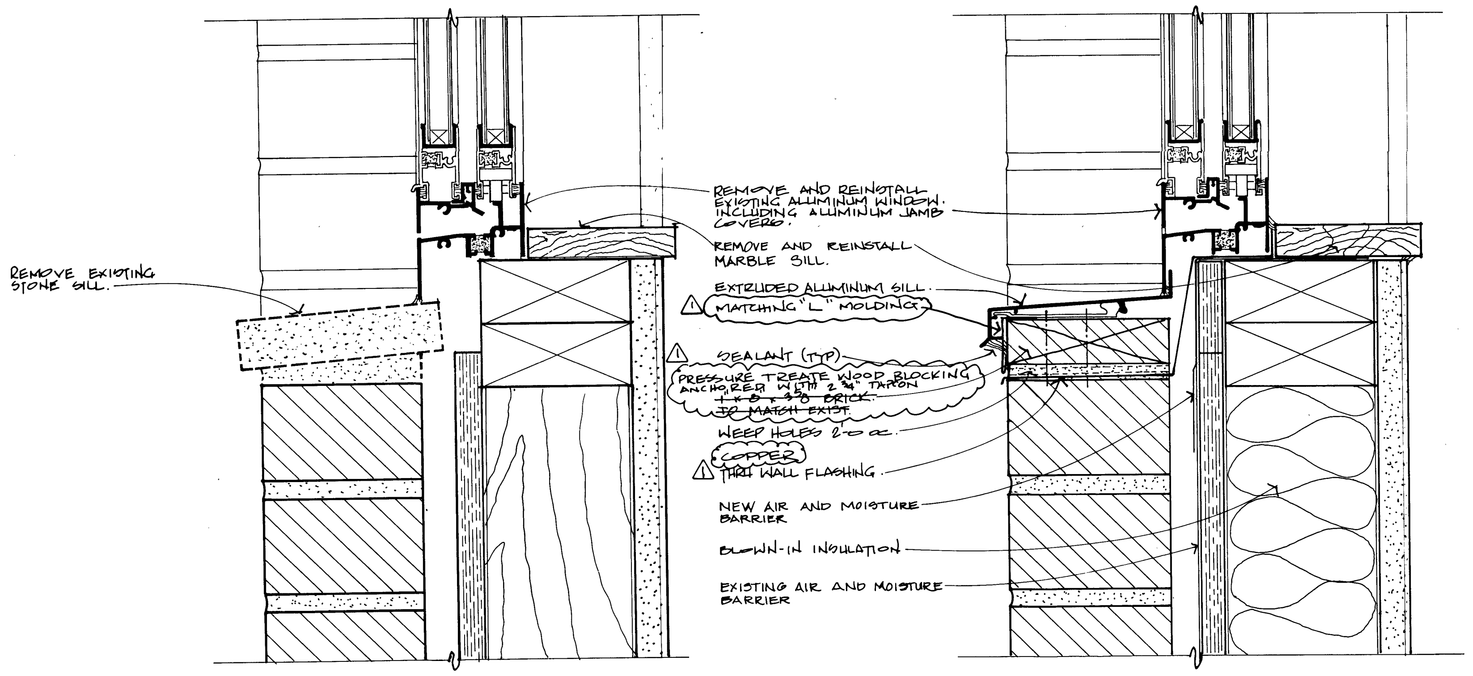

REMOVAL OF EXISTING SILL

9 / 7

6" = 1'-0

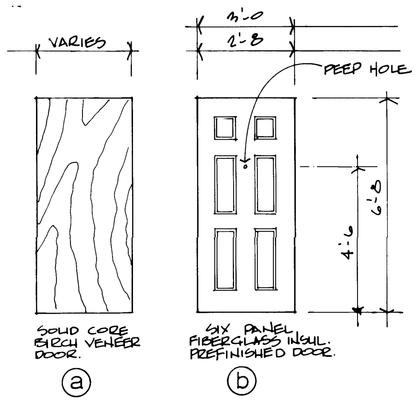

DOOR TYPES

7 / 4,5

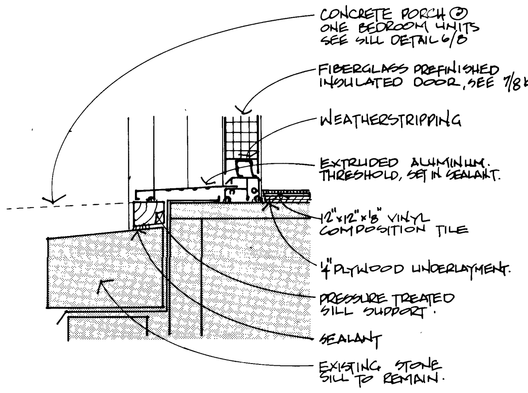

SILL DETAIL

3 / 4,5

3" = 1'-0

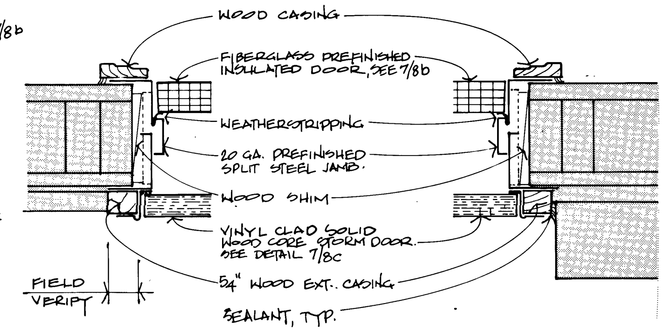

JAMB DETAIL

2 / 4,5

3" = 1'-0

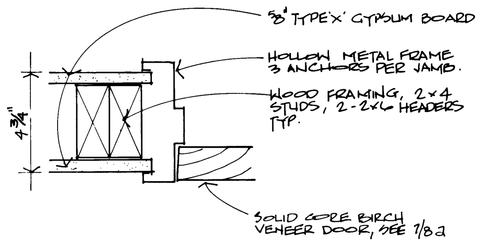

JAMB DETAIL

1 / 4,5

3" = 1'-0

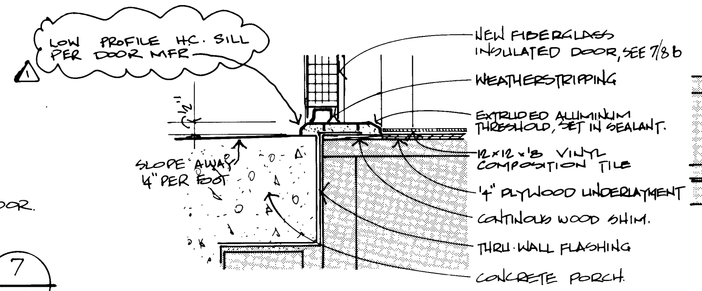

SILL DETAIL

6 / 4,5

3" = 1'-0

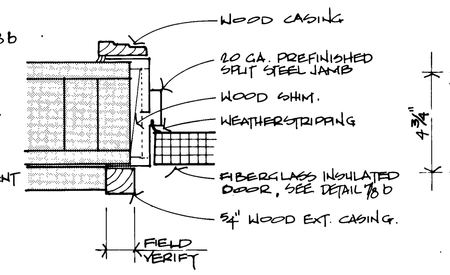

JAMB DETAIL

5 / 4,5

3" = 1'-0

JAMB DETAIL

4 / 5

3" = 1'-0

CONCRETE FOOTING DETAIL

13 / 8

1½" = 1'-0

NEW SILL DETAIL

8 / 7

6" = 1'-0

TOT LOT PLAN

12 / 1

SECTION

11 / 1,5,6,8

¾" = 1'-0

ELEVATION/SECTION

10 / 6

¾" = 1'-0

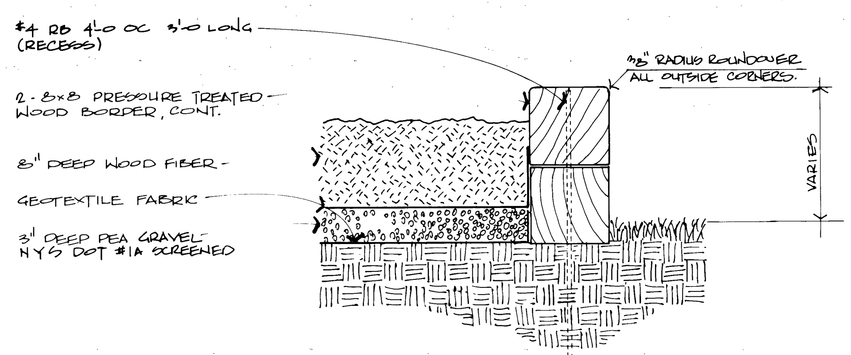

GENERAL CONTRACTOR TO REMOVE ALL SOD UNDER TOT LOT. TOT LOT TO BE INSTALLED LEVEL AND THE GROUND AROUND PLAY AREA TO BE GRADED WITH NEW TOP SOIL AND SEEDED AS REQUIRED TO ALLOW RAIN WATER TO RUN OFF. CONTRACTOR TO FIELD VERIFY EXISTING CONDITIONS AND WATER RUN OFF AND NOT TO DEGRADE EXISTING SITE CONDITIONS.

WOOD BORDER DETAIL

16 / 8

1½" = 1'-0

SLIDE/HORIZONTAL LADDER

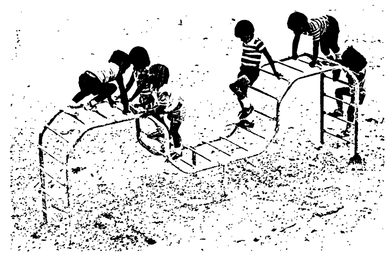

TWO-WAY CLIMBER

TOT LOT EQUIPMENT

15 / 8

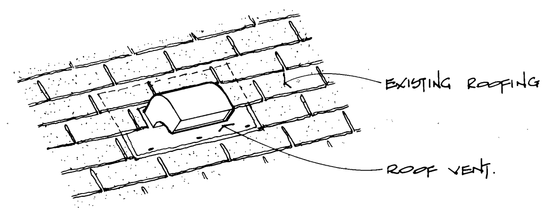

BATH FAN ROOF PENETRATION

14 / M3,M4

NTS

THE INFORMATION ON THIS DRAWING HAS BEEN PROVIDED BY THE CONTR AND IS FOR INFORMATION ONLY. FUTURE CONSTRUCTION REQUIRES ADEQUATE INVESTIGATION
DATE 11 APR 94 WAS INT.

REGISTERED ARCHITECT — RECORD DRAWING — AS BUILT

WARNING: ALTERATIONS TO THIS DOCUMENT NOT CONFORMING TO SECTION 7209.2 or 69.5(b), STATE EDUCATION LAW, ARE PROHIBITED.

NOT PUBLISHED. ALL RIGHTS RESERVED.

WAS | | | RMG

AUDIT INSTRUCTIONS

SHEET NUMBER

REVISIONS
⚠ 11 APRIL 94 - AS BUILTS

JORDAN GARDENS - CIAP
NIAGARA FALLS HOUSING AUTHORITY
HIGHLAND AVE. AT EASTON DR. NIAGARA FALLS, NEW YORK

NY 11-2

PLANS, SECTIONS, DETAILS
TOT LOT, SILL REPLACEMENT, JAMB DETAILS

Trautman King Markwart Associates PC. Architects and Engineers
470 Franklin Street Buffalo, NY 14202 (716) 883-4400

TRAUTMAN ASSOCIATES

92025
SCALE NOTED
16 NOV 92

8

TAUTMAN BLUE SUPPLY COMPANY 848848